
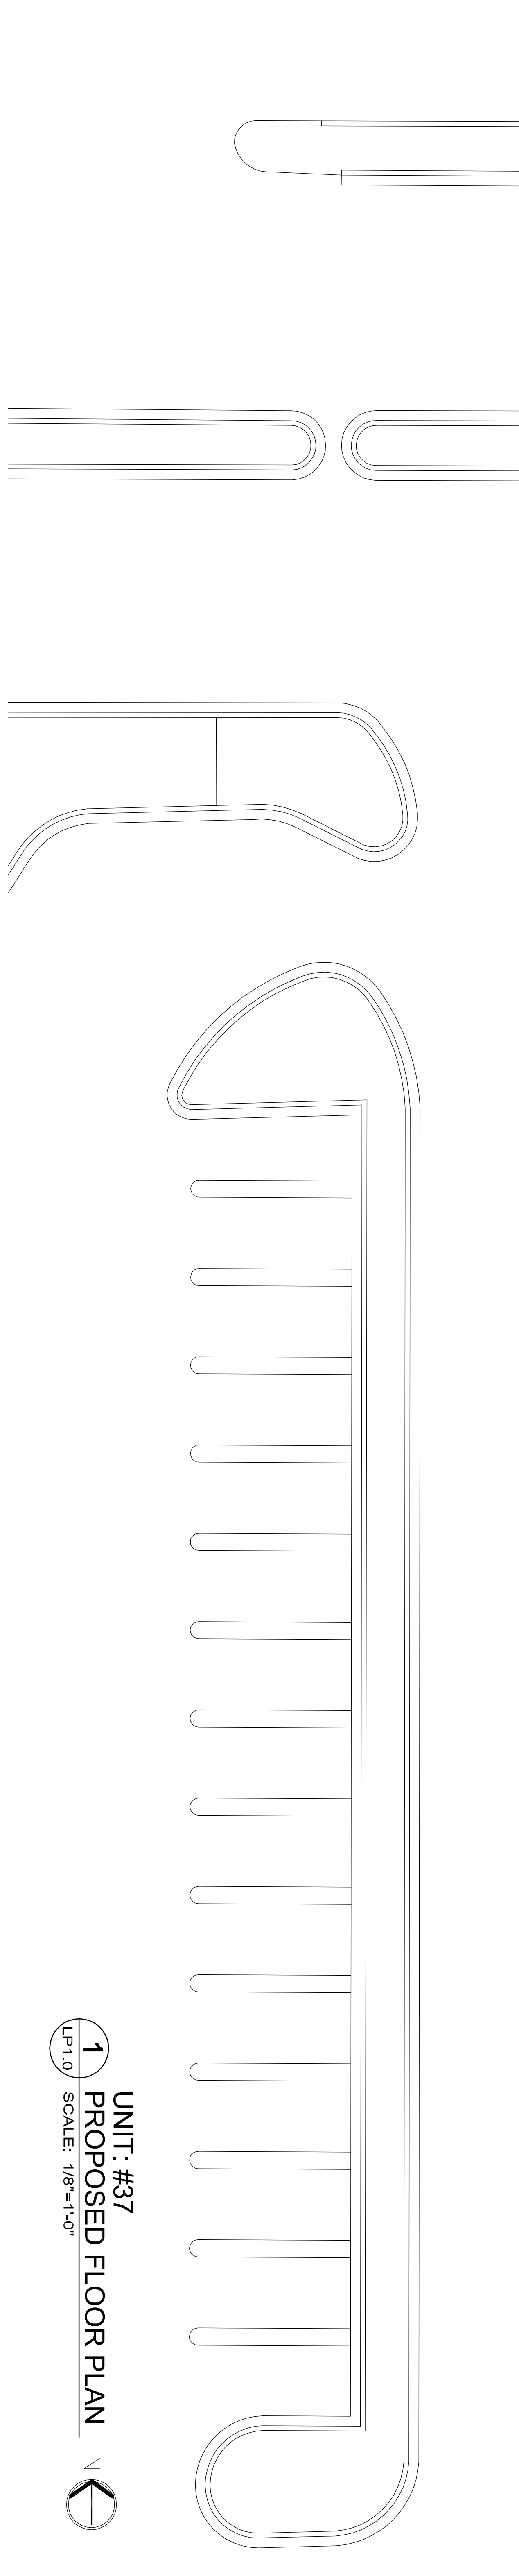


UNIT: #37

EXISTING  
**FIFTH THIRD BANK**  
 (SUITE 1366)  
**±4,344 S.F.**  
 EL. +0'-0"

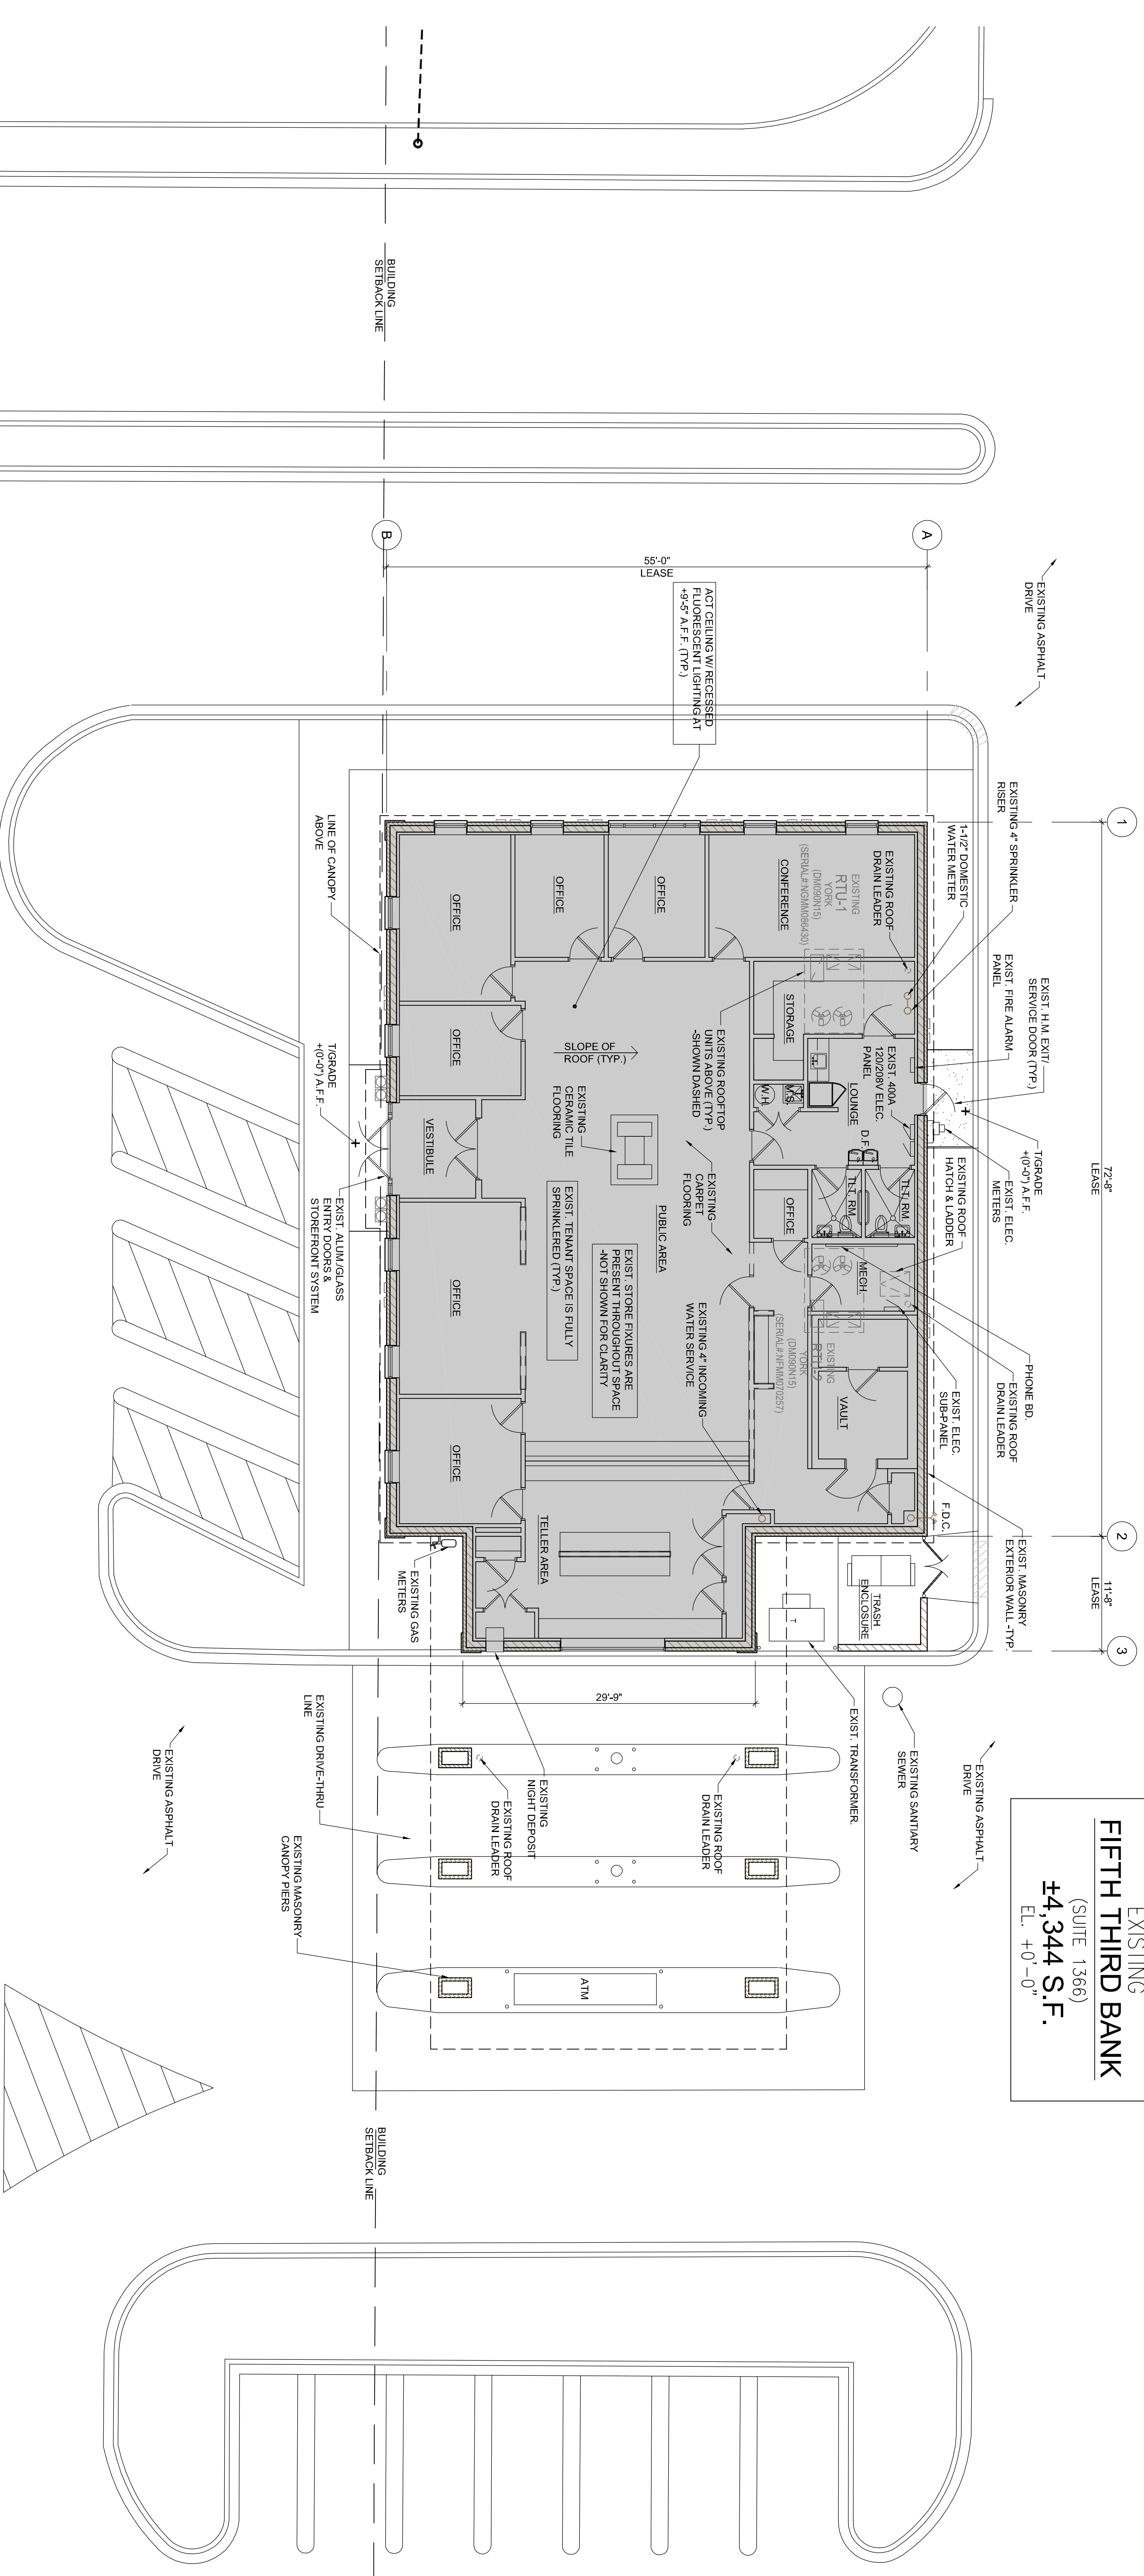

UNIT: #37  
**1** PROPOSED FLOOR PLAN  
 SCALE: 1/8"=1'-0"

**PFDA**  
 ARCHITECTS, INC.

2803 BUTTERFIELD RD.  
 SUITE 340  
 OAK BROOK, IL 60523  
 TEL: (312) 795-1245  
 FAX: (312) 795-6123



**IRC**  
**RETAIL CENTERS**  
 814 COMMERCE DRIVE  
 SUITE 300  
 OAK BROOK, IL 60523

PROJECT:  
 AS-BUILT  
 FLOOR PLANS  
 RED TOP PLAZA  
 (UNIT #37)  
 1366 S. MILWAUKEE AVENUE  
 LIBERTYVILLE, IL

SHEET TITLE:  
 PROPOSED  
 FLOOR PLAN

NO.	DATE	DESCRIPTION
06.06.19	FOR REVIEW	

COPYRIGHT - PFDA, INCORPORATED  
 ALL DRAWING AND WRITTEN INFORMATION  
 HEREON IS THE PROPERTY OF PFDA, INC.  
 NO PART OF THIS DRAWING SHALL BE  
 REPRODUCED OR TRANSMITTED IN ANY  
 FORM OR BY ANY MEANS, WITHOUT WRITTEN CONSENT.

DRAWN BY: \_\_\_\_\_ CHECKED BY: \_\_\_\_\_

SHEET:  
**LP1.0**

JOB NO. 19047