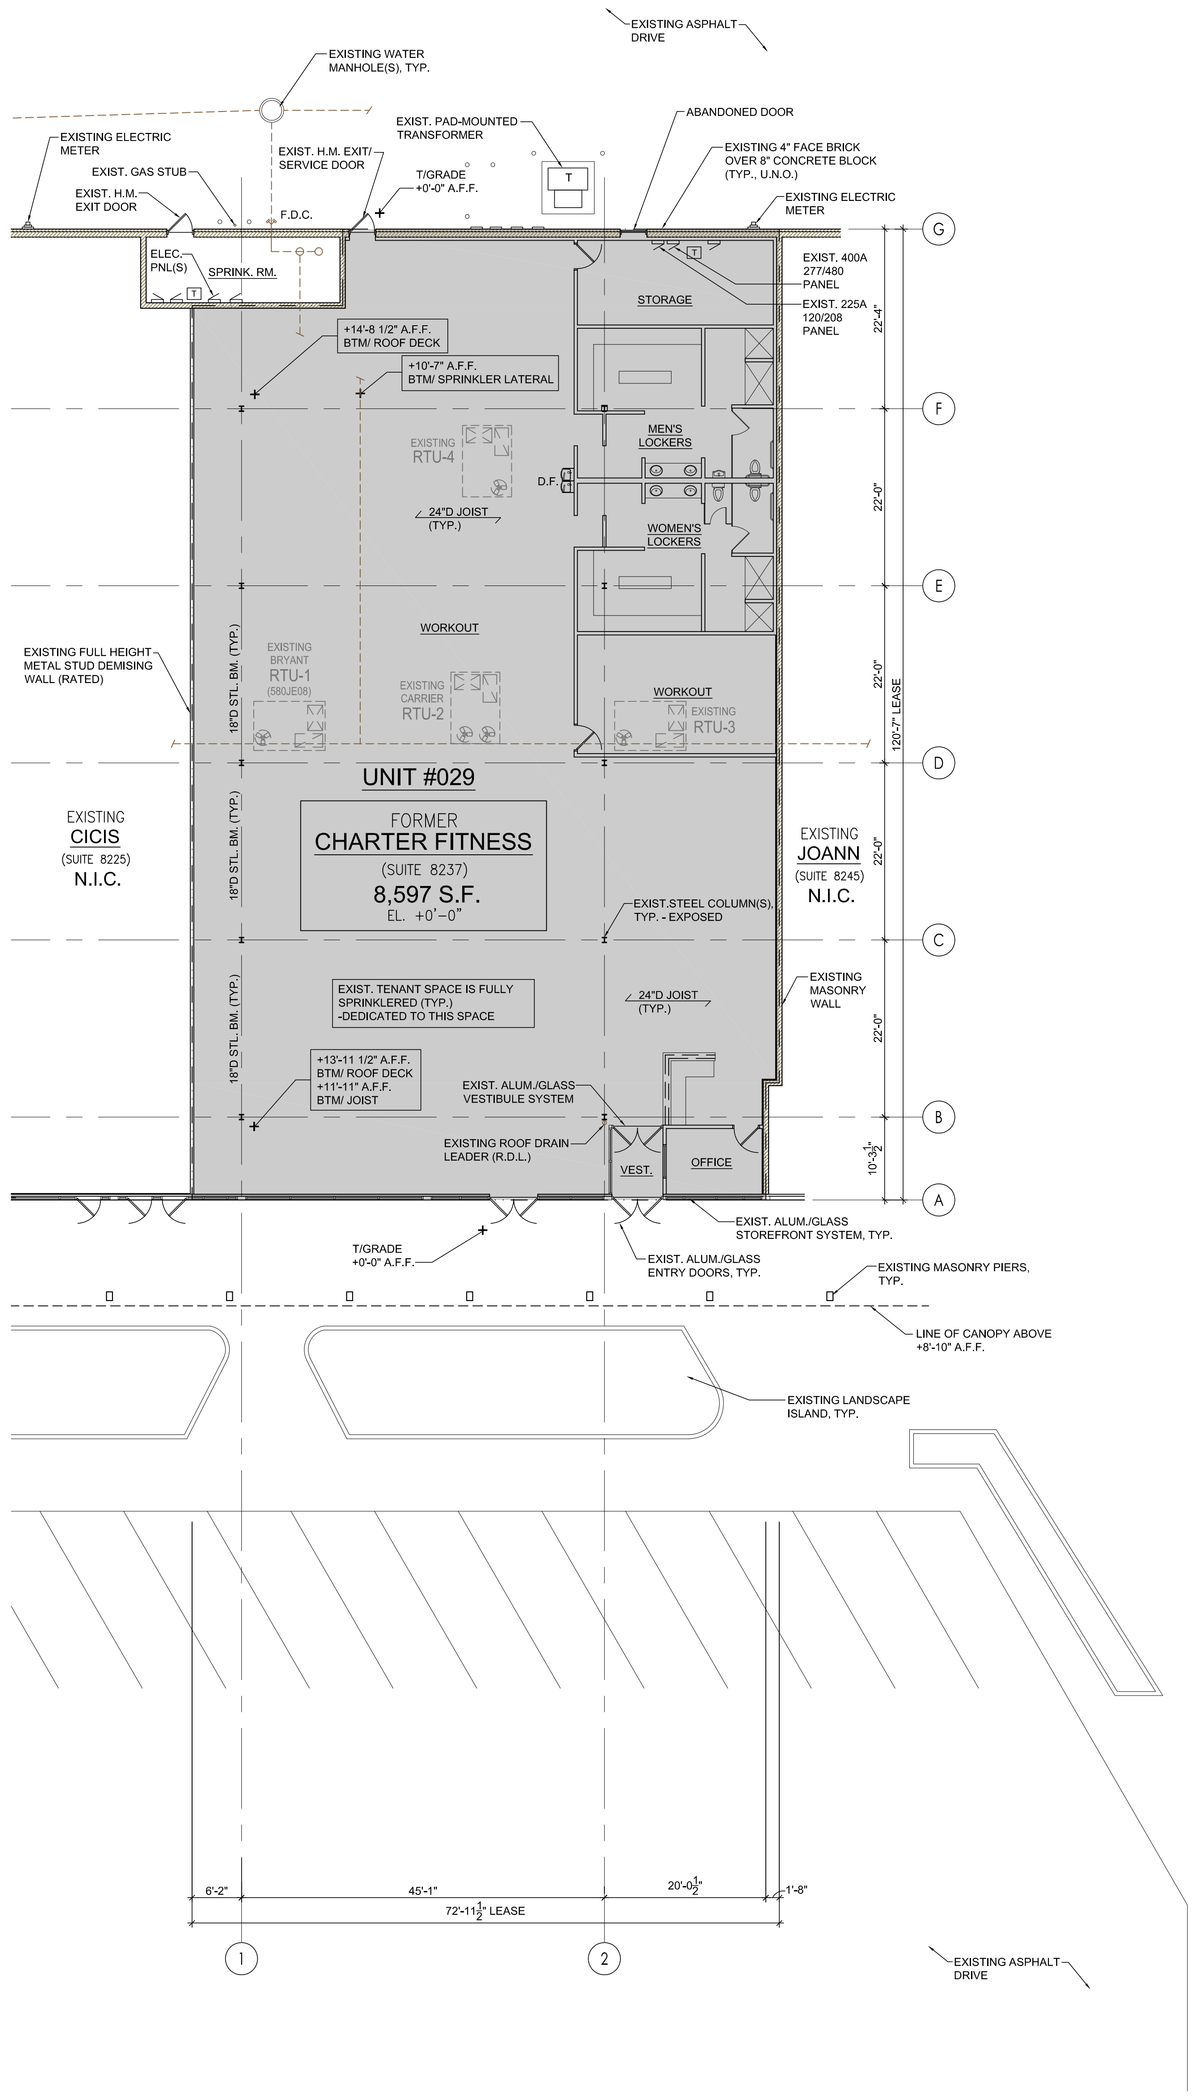

1 UNIT #029 AS-BUILT FLOOR PLAN
AS1.2 SCALE: 3/32"=1'-0"

N

PFDA ARCHITECTS, INC.
2803 BUTTERFIELD RD.
SUITE 340
OAK BROOK, IL 60523
TEL: (312) 795-1245
FAX: (312) 795-6123

OWNER:

IRC RETAIL CENTERS
814 COMMERCE DRIVE
SUITE 300
OAK BROOK, IL 60523

PROJECT:

AS-BUILT PLANS

FOUR FLAGGS MARKETPLACE
(UNITS 004, 006, 029)
8217-8247 WEST GOLF RD.
NILES, IL 60714

SHEET TITLE:

AS-BUILT FLOOR PLAN

NO.	DATE	DESCRIPTION
	11.13.18	FOR REVIEW

COPYRIGHT - PFDA, INCORPORATED
ALL DRAWN AND WRITTEN INFORMATION APPEARING HEREIN SHALL NOT BE DUPLICATED, DISCLOSED OR OTHERWISE WITHOUT WRITTEN CONSENT.

DRAWN BY: | CHECKED BY:

SHEET:

AS1.2

JOB NO. 18121